

**STATE OF UTAH**  
**DEPARTMENT OF NATURAL RESOURCES**  
**DIVISION OF OIL, GAS AND MINING**  
 1594 West North Temple - Suite 1210  
 Box 145801  
 Salt Lake City, Utah 84114-5801  
 Telephone: (801) 538-5291  
 Fax: (801) 359-3940

RECEIVED  
 JAN 30 2015  
 DIV. OF OIL, GAS & MINING

**LARGE MINING OPERATIONS PROGRESS REPORT**

**January 1, 2014 to December 31, 2014**

The information required in this form is based on provisions of the Mined Land Reclamation Act, Title 40-8, and the R647 rules under the Utah Minerals Regulatory Program.

1. Mine Permit Number: M/0049/0071
2. Mine Name: Sage Canyon Mass Excavation
3. Name of Operator/Permittee: Geneva Rock Products, Inc.

Note: If Operator's address, company representative or phone number have changed, please provide a replacement page for the Notice of Intention together with form MR-REV available on the Division's web page at [https://fs.ogm.utah.gov/pub/mines/minerals\\_related/forms/MR-REV.pdf](https://fs.ogm.utah.gov/pub/mines/minerals_related/forms/MR-REV.pdf).

4. Report the gross amount of ore mined and waste moved:

Gross Ore Mined 4,017,456 Tons, or \_\_\_\_\_ yd<sup>3</sup>  
 Waste Material Moved 0 Tons, or \_\_\_\_\_ yd<sup>3</sup>

5. Disturbance at the end of 2013 22 Acres  
 New Disturbance Created during 2014 5 Acres  
 Area Reclaimed and Fully Released during 2014 0 Acres  
 Total Disturbed Area at the end of 2014 27 Acres\*  
 Permitted/Bonded Acreage 137 Acres

\*The total disturbed area should not be greater than the permitted/bonded acreage

6. Briefly describe the reclamation work performed during the past year. (Submit form MR-SITE ([https://fs.ogm.utah.gov/pub/mines/minerals\\_related/forms/MR-SITE.pdf](https://fs.ogm.utah.gov/pub/mines/minerals_related/forms/MR-SITE.pdf)) to apply for full or partial bond/site release). Attach additional sheets if needed.  
No reclamation work has been performed during this period.

7. For large mines, include an updated map depicting surface disturbance and reclamation performed during the year (Rule R647-4-105).

**I hereby certify, under penalties of law, the information provided in this report is true and correct to the best of my knowledge and belief.**

Name (Typed or Print): Brent R. Sumsion

Title of Operator: Properties and Environmental Manager

Signature of Operator: 

Date: Jan. 30, 2015

pb


O:\FORMS\reports\MR-AR-LMO2010.doc



RECEIVED

JAN 30 2015

DIV. OF OIL, GAS & MINING

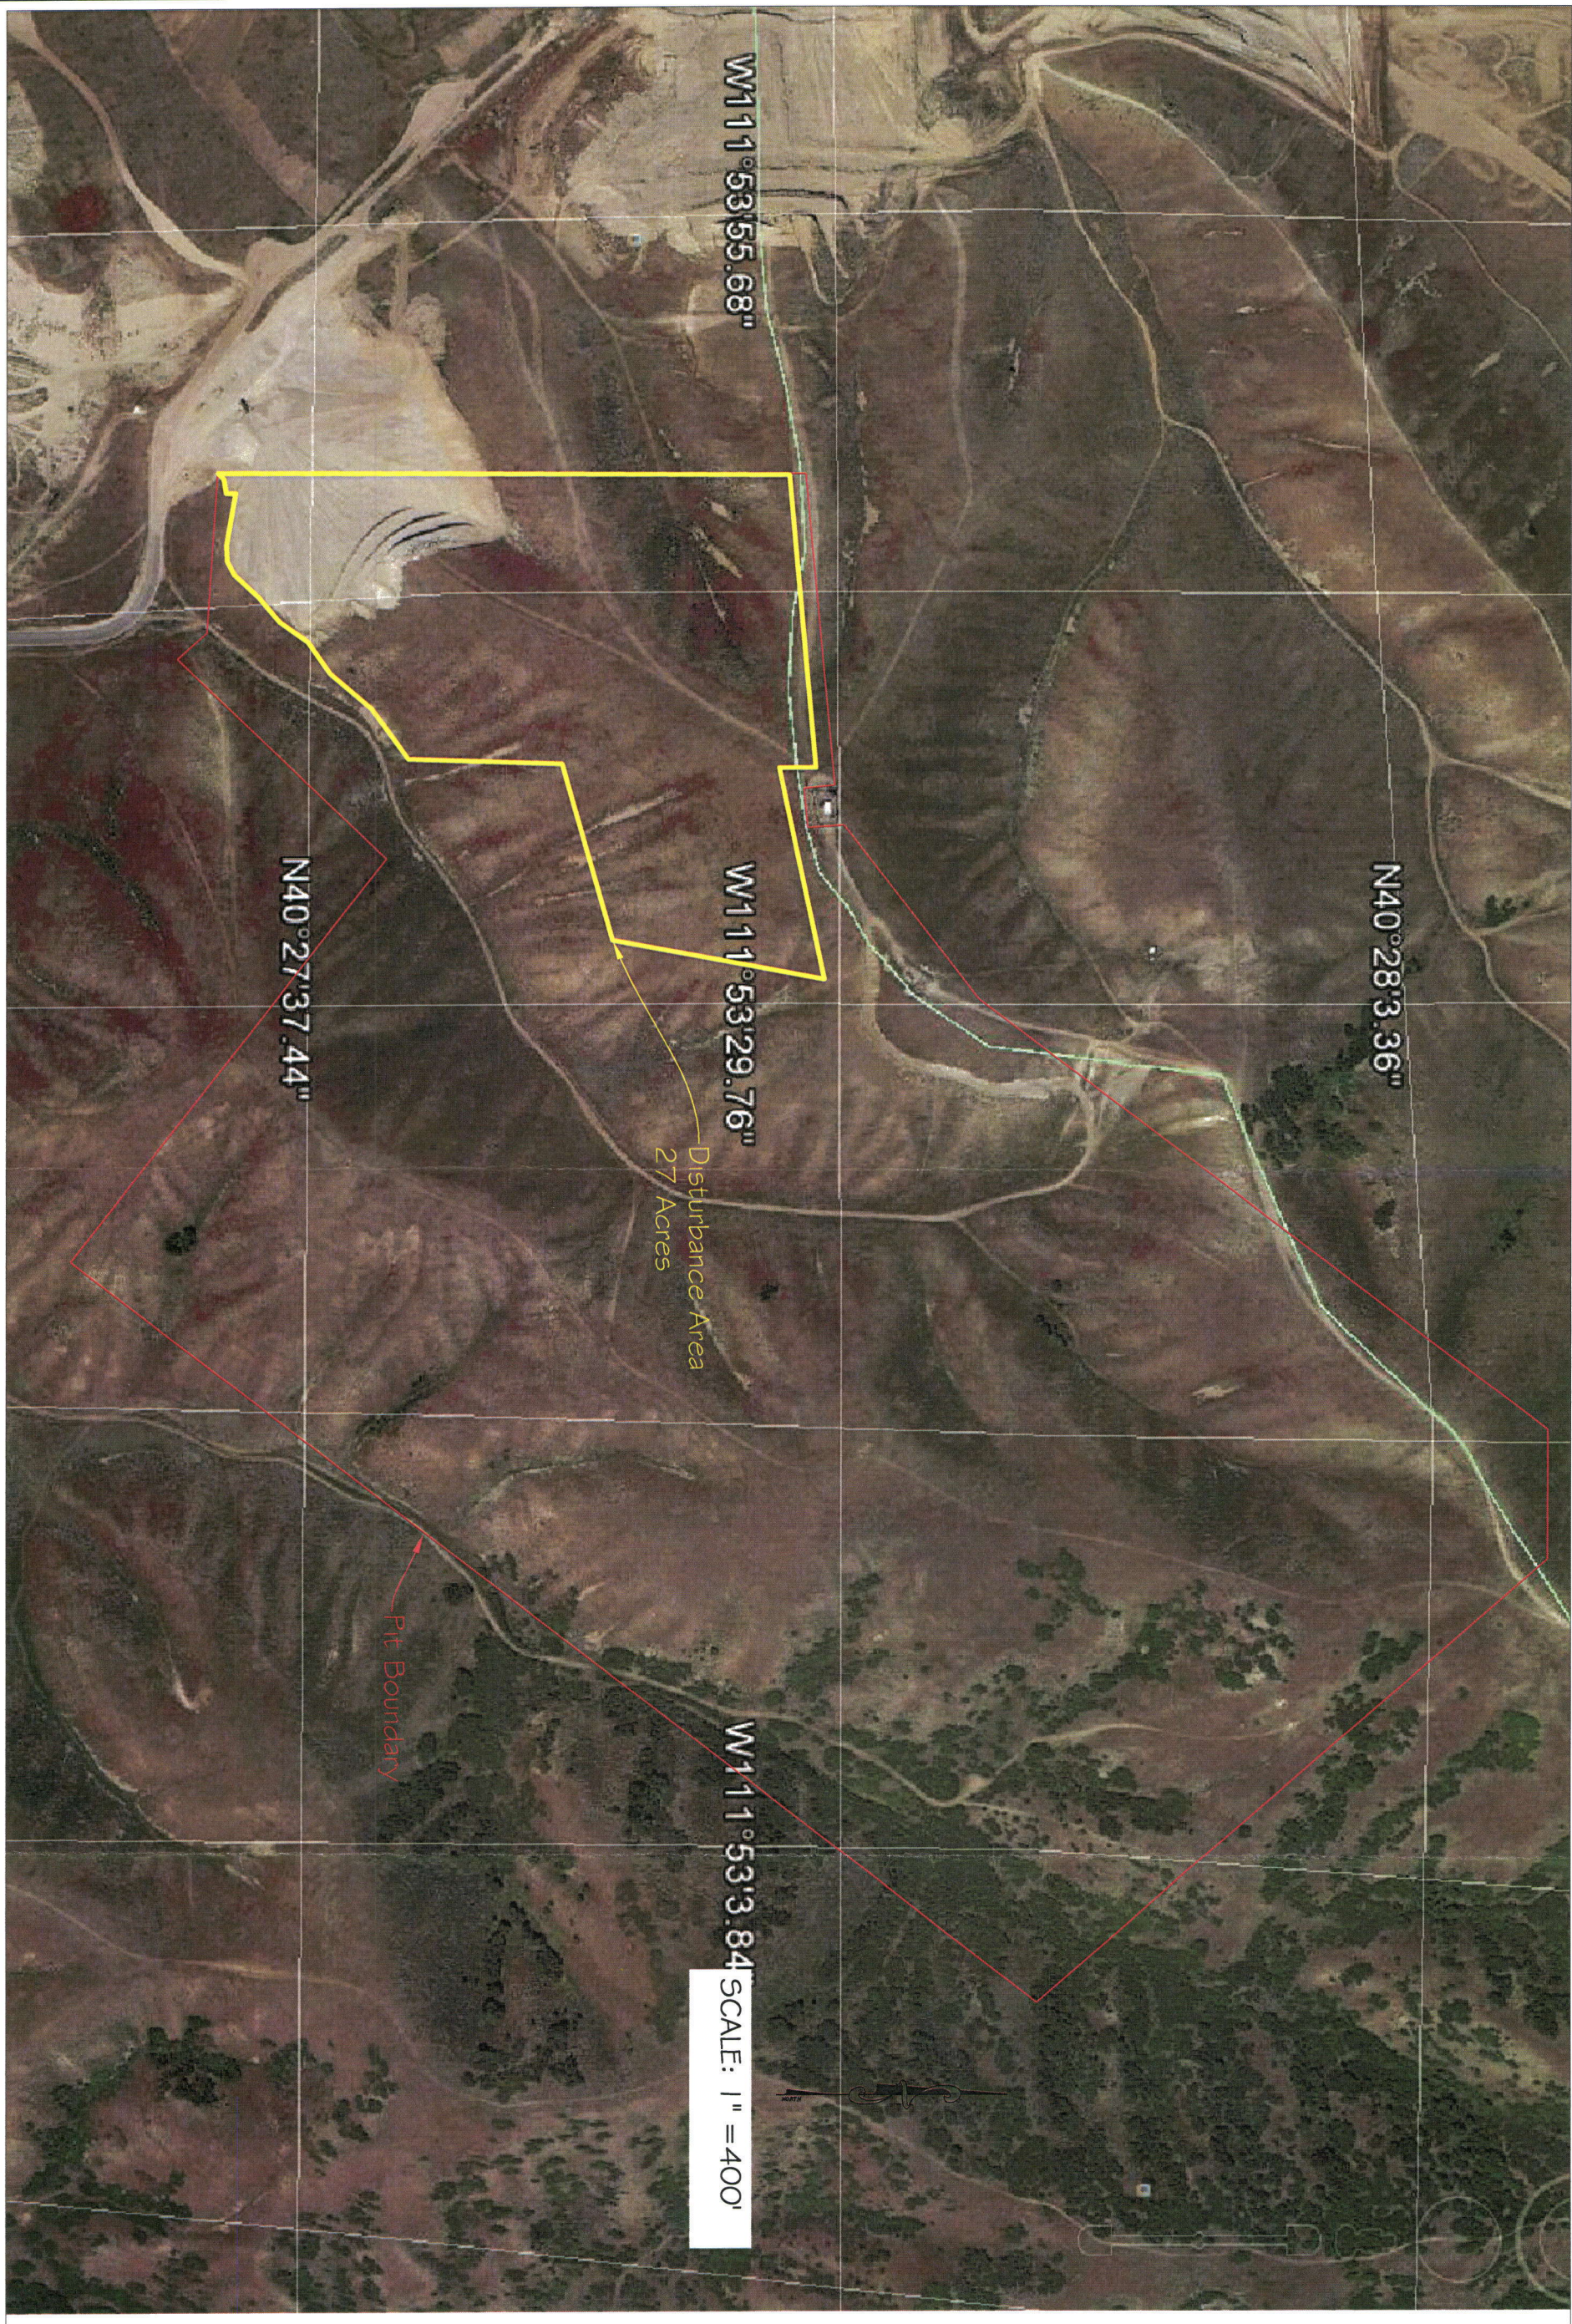

Drawn: B SUMSION	TITLE: Sage Canyon Mass Grading	Engineer:							
Checked: BSVCC									
Approved:									
Date: 1/30/15	ISSUED FOR INTERNAL REVIEW	Revision: 00							
Dwg. No. CCI-1			NO.	DATE:	DESCRIPTION:		BY:		

Geneva Rock Sage Canyon  
NOI Mass Grading Operation  
Current Disturbance Map

**GENEVA  
ROCK**  
A LARSEN COMPANY

Geneva Rock Products, Inc.  
1556 West 400 North  
Orem, Utah 84057  
801-765-7800